

PERMIT NUMBER

Installer Kurt L. Smith License # ZH 103219
 Installer Mobile Phone # 360.397.0586

Address of home
being installed


Manufacturer Line Oak Length x width 28 x 48

NOTE: If house is a single wide fill out one half of the blocking plan
If house is a triple or quad wide sketch in remainder of home

I understand Lateral Arm Systems cannot be used on any home (new or used) where the sidewalk does exceed 5 ft 4 in.

Installer's Initials

Typical Dier spacing

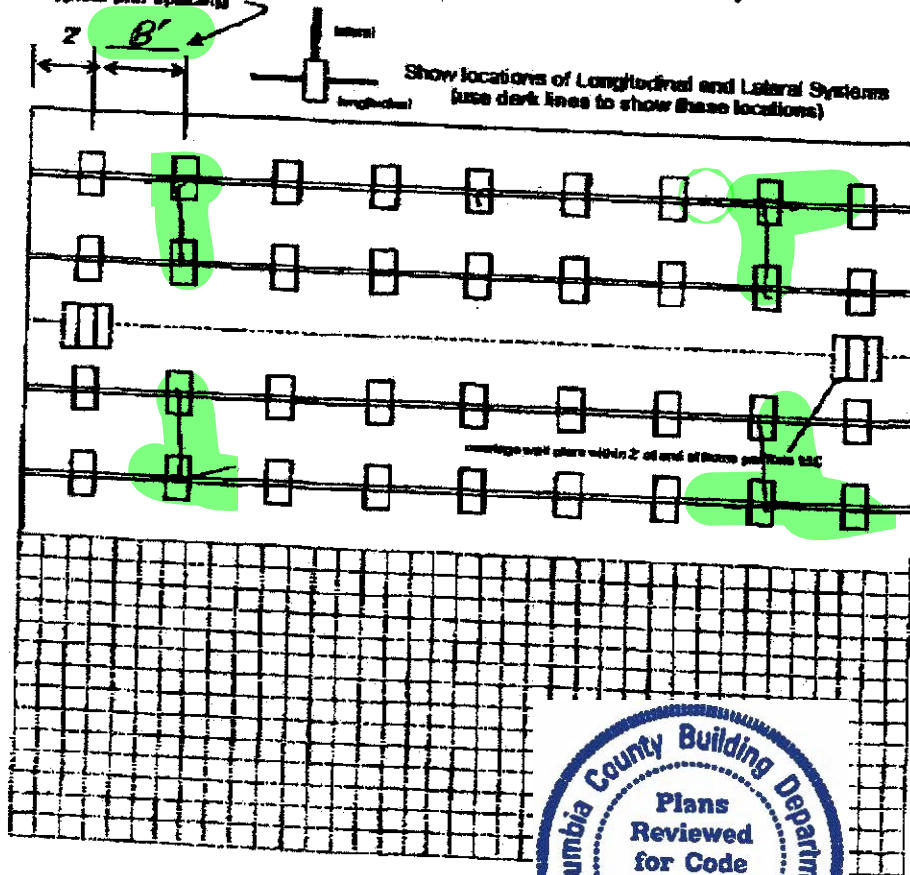

PERMIT WORKSHEET

page 1 of 2

New Home ☒ **Used Home** ☐

Home installed to the Manufacturer's Installation Manual ☒

Home is installed in accordance with Rule 15-C

Single wide ☐ Wind Zone II ☒ Wind Zone III ☐

Double wide ☒ Installation Deal # 10534

Triple Guard ☐ Serial #

Roof System: Typical Hinged

PER SPACING TABLE FOR USED HOMES

Load bearing capacity	Footer also (sq in)	18" x 18" (259)	18 1/2" x 18 1/2" (342)	24" x 24" (432)	22" x 22" (484)*	24" x 24" (576)*	26" x 26" (676)
1000 psf	3'	4'	5'	6'	7'	8'	
1500 psf	4' 8"	6'	7'	8'	9'	10'	
2000 psf	6'	8'	9'	10'	11'	12'	
2500 psf	7' 6"	9'	10'	11'	12'	13'	
3000 psf	9'	10'	11'	12'	13'	14'	
3500 psf	10'	11'	12'	13'	14'	15'	

* Interpolated from Table 1A-1, also see notes below.

* Interpolated from Plate 15C-1 pier spacing table

PIER PAD SIZES

Beam pier pad size 17.5 x 26.0

Partmeter plus post size ref

Other plate sizes (required by the mfg.) flex

 Draw the approximate locations of manhole wall openings 4 feet or greater. Use this symbol to show the piers.

List all vent pipe openings greater than 4 feet and their pier pad sizes below.

Opening	Pier pad size
---------	---------------

TIEDOWN COMPONENTS

Longitudinal Stabilizing Device (LSD)
Main function:

Longitudinal Stabilizing Device w/ Lateral Arms
Manufacturer

Manufacturer _____

POPULAR PAD SIZES

Pad Size	Sq. In.
18 x 18	252
18 x 18	288
18.5 x 18.5	342
16 x 22.5	360
17 x 22	374
13 1/4 x 28 1/4	348
20 x 20	400
17 3/16 x 25 3/16	441
17 1/2 x 25 1/2	446
24 x 24	576
28 x 28	672

AMINO ACIDS

4R 5R

FRAME TIES

within 2' of end of home
spaced at 8' 4" oc

OTHER DES

Sidewall	Number
Longitudinal	_____
Marriage wall	_____
Shoewall	_____

2.004

FAX No.

2024/OCT/08/TUE 08:53

PERMIT NUMBER

PERMIT WORKSHEET

page 2 of 2

POCKET PENETROMETER TEST

The pocket penetrometer tests are rounded down to 1500 psi or check here to declare 1000 lb. soil without testing.

X 5 X X

POCKET PENETROMETER TESTING METHOD

1. Test the perimeter of the home at 6 locations.
2. Take the reading at the depth of the footer.
3. Using 500 lb. increments, take the lowest reading and round down to that increment.

X X X

TORQUE PROBE TEST

The results of the torque probe test is NA NOT inch pounds or check here if you are declaring 5' anchors without testing. A test showing 275 inch pounds or less will require 5 foot anchors.

Note: A state approved lateral arm system is being used and 4 ft. anchors are allowed at the sidewall locations. I understand 5 ft. anchors are required at all centerline tie points where the torque test reading is 275 or less and where the mobile home manufacturer may require anchors with 4000 lb holding capacity.

RLK Installer's Initials

ALL TESTS MUST BE PERFORMED BY A LICENSED INSTALLER

Installer Name

Rusty Kuehn

Date Tested

10-16-24



Electrical

Connect electrical conductors between multi-wide units, but not to the main power source. This includes the bonding wire between multi-wide units. Pg. 15C1

Plumbing

Connect all sewer drains to an existing sewer tap or septic tank. Pg. 15C1

Connect all potable water supply piping to an existing water meter, water tap, or other independent water supply systems. Pg. 15C-1

Site Preparation

Debris and organic material removed ☒
 Water drainage: Natural ☒ Swale ☒ Fed ☒ Other ☐

Fastening multi-wide units

Floor: Type Fastener: Long Length: 6" Spacing: 20"
 Walls: Type Fastener: 5/8" Length: 4" Spacing: 24"
 Roof: Type Fastener: 5/8" Length: 1 1/2" Spacing: 48"
 For test homes a min. 30 gauge, 8" wide, galvanized metal strip will be centered over the peak of the roof and fastened with gable roofing nails at 2' on center on both sides of the centerline.

Gasket installation instructions

I understand a properly installed gasket is a requirement of all new and used homes and that condensation, mold, mildew and buckled sheetrock walls are a result of a poorly installed or no gasket being installed. I understand a strip of tape will not serve as a gasket.

Installer's Initials RLK

Type gasket Full length
 Pg. 15C1

Installed:
 Between Floors Yes ☒
 Between Walls Yes ☒
 Bottom of ridgebeam Yes ☒

Weatherproofing

The bottomboard will be repaired and/or taped. Yes ☒ Pg. 15C1
 Siding on units is installed to manufacturer's specifications. Yes ☒
 Fireplace chimney installed so as not to allow intrusion of rain water. Yes ☒

Miscellaneous

Siding to be installed. Yes ☒ No ☐
 Dryer vent installed outside of skirting. Yes ☐ N/A ☒
 Range downflow vent installed outside of skirting. Yes ☐ N/A ☒
 Drain lines supported at 4 foot intervals. Yes ☐
 Electrical crossovers protected. Yes ☒
 Other: ☐

Installer verifies all information given with this permit worksheet is accurate and true based on the manufacturer's installation instructions and or Rule 16C-1 & 2

Installer Signature

Date 10-16-24

License Number: IH / 1038219 / 1 Name: RUSTY L. KNOWLES

Order #: 6147	Label #: 108534	Manufacturer:	(Check Size of Home)
Homeowner:	Year Model:		Single _____
Address:	Length & Width:		Double _____
			Triple _____
City/State/Zip:	Type Longitudinal System:		HUD Label #:
Phone #:	Type Lateral Arm System:		Soil Bearing / PSP:
Date Installed:	New Home: _____ Used Home: _____		Torque Probe / in-lbs:
Installed Wind Zone:	Data Plate Wind Zone:		Permit #:

Note:



**STATE OF FLORIDA
INSTALLATION CERTIFICATION LABEL**

108534

LABEL #

DATE OF INSTALLATION

RUSTY L. KNOWLES

NAME

IH / 1038219 / 1

6147


LICENSE #

ORDER #

CERTIFIES THAT THE INSTALLATION OF THIS MOBILE HOME IS
IN ACCORDANCE WITH FLORIDA STATUTES 320.8248, 320.8315
AND RULES OF THE HIGHWAY SAFETY AND MOTOR VEHICLES.

INSTRUCTIONS

PLEASE WRITE DATE OF
INSTALLATION AND AFFIX
LABEL NEXT TO HUD LABEL.
USE PERMANENT INK PEN
OR MARKER ONLY.
COMPLETE INFORMATION
ABOVE AND KEEP ON FILE
FOR A MINIMUM OF 2 YEARS.
YOU ARE REQUIRED TO
PROVIDE COPIES WHEN
REQUESTED.

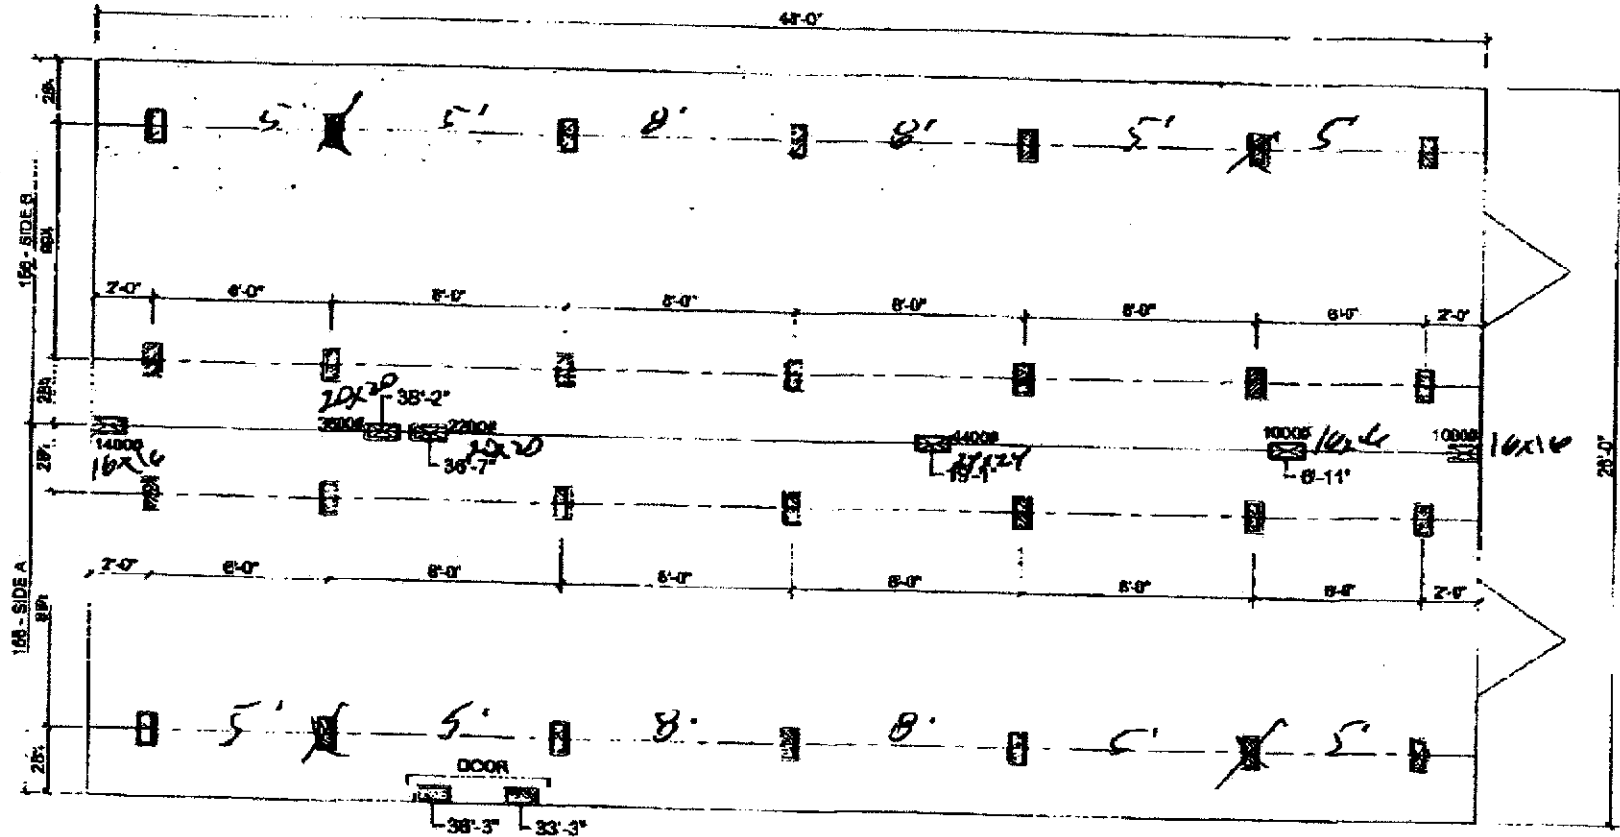

☒ MARRIAGE LINE OPENING SUPPORT PERVTP.

SUPPORT PIER/TYP

FOUNDATION NOTES:

- THIS DRAWING IS DESIGNED FOR THE STANDARD WIND ZONE AND IS TO BE USED IN CONJUNCTION WITH THE INSTALLATION MANUAL AND ITS SUPPLEMENTS.
- FOOTINGS ARE SHOWN FOR EXAMPLE ONLY QUANTITY AND SPACING MAY VARY BASED ON PAD TYPE, SOIL CONDITION, ETC.
- FOOTINGS ARE REQUIRED AT SUPPORT POSTS, SEE INSTALLATION MANUAL FOR REQUIREMENTS.

11/10/22

Live Oak Homes
MODEL: H-2483N-PS - 28 X 48 (BOX)
3-BEDROOM / 2-BATH

(99-1/2" I-BEAM SPACING)

H-2483N-PS