


Jared Craig Survey Site Plan

767 NW Bridgewater
Lake City, FL 32055

Pool Surface Area: 365sqft
Paver Deck: 1048sqft

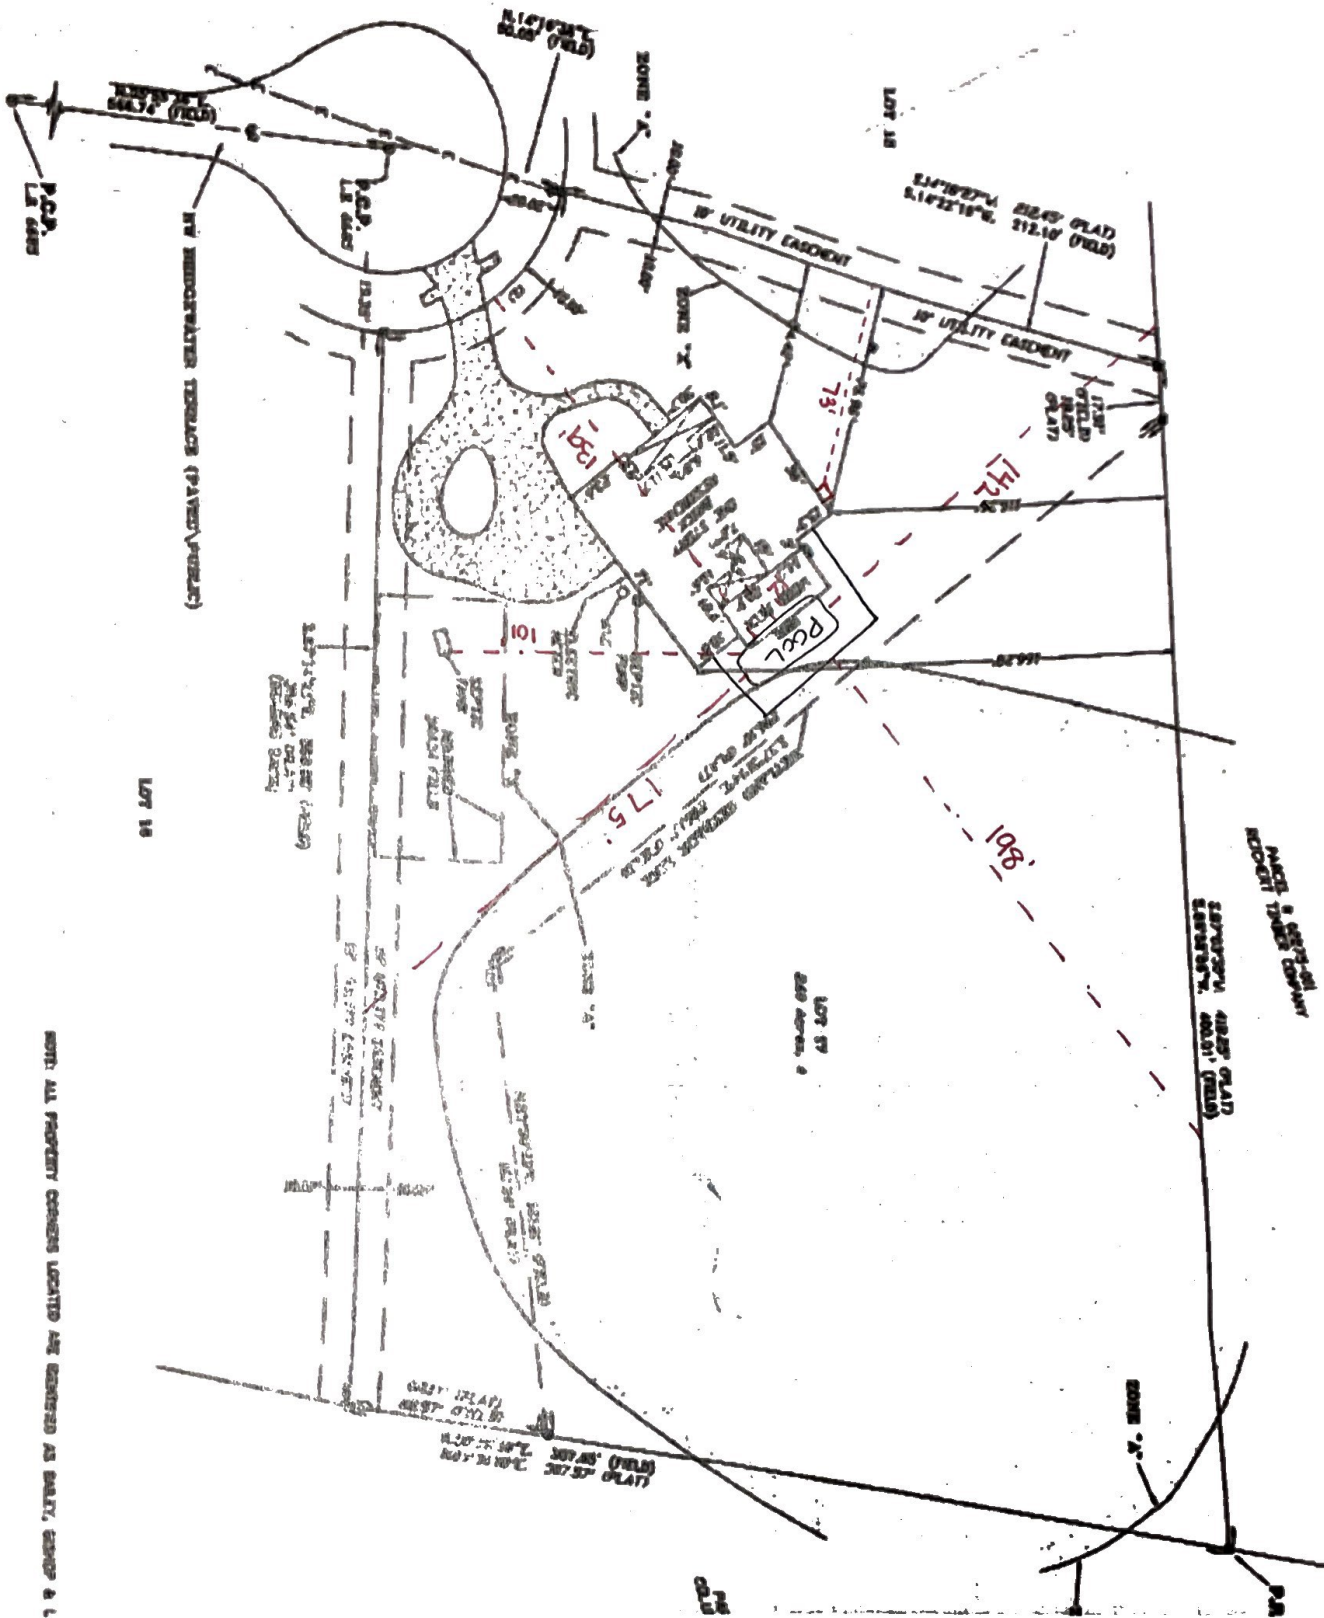

CURVE TABLE

NO.	RADIUS	DELTA	ARC	PERCENT	CHORD	CHORD BEARING
1	60.0'	78.1° 00'	61.8'	44.7%	78.1'	S 17° 12' 10" W
2	60.0'	78.1° 00'	61.8'	44.7%	78.1'	S 17° 12' 10" W

FHA STANDARD REQUIREMENTS:

SEPTIC TO RESIDENCE - 60.0'
SEPTIC TO WELL - 175'
SEPTIC TO BATH - PROPERTY LINE - 10.0'
WELL TO RESIDENCE - 44.7'
WELL TO BATH FIELD - 175'
WELL TO WEST PROPERTY LINE - 80'

NOTE: ALL PROPERTY CORNERS LOCATED ARE SHOWN AS BUILT, GROUP 4 & 5